Labor and Materials

1	Copper / Lead — Connection	3/4	$ 1.46
1	Curb — Cock / Valve / T. S. & V.	3/4 in	$ 1.93
1	Service Box — Old returned — Short 3½ x 4½ / Long 4½ x 5½ / Buff. or Rdway		$ 1.77
12	Ft. 3/4 in. — Copper / Galv Iron / Cast Iron — Pipe at		$ 2.64
	Nipples in. at		$
	Bushings to in. at		$
	Red'g / Inc'g — Couplings to in. at		$
	Union in. at		$
	Meter in. at		$
	Lead Joints at		$
	Leadite Joints at		$
	Hrs. Foreman at		$
1½	Hrs. Chauffeur at		$ .31
	Hrs. Tapper at		$
8	Hrs. Labor at		$ 3.60
	Hrs. Labor at		$
	Hrs. Compressor at		$
	Compensation Ins.		$ .12
	Trucking		$ 1.—
	Builders Use of Water		$
			$
			$
			$
			$
			$ 12.83

Sept 17

OCT 30 1937

St. 7
Pl.
Ave. No. 3

Name of Owner

Seaver

Labor and Mat'l. Report Oct 8 19 37

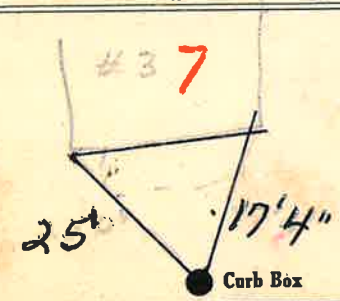

6 Main

Elev. of Main at tap 4½

Gate at • Gate at

12' to MAIN
3/4" COPPER

● Curb Box

old stub off

TAX ID# 302.16-6-24

Bill