18

Labor and Materials

1	Copper ~~Lead~~	Connection 3/4	$ 1.46
1	Curb	Cock ~~Valve~~ ~~T. S. & V.~~ 3/4 in	$ 1.93
1	Service Box Old returned	Short ~~3½ x 4½~~ Long 4½ x 5½ Buff. or Rdway	$ 1.77
21	Ft. 3/4 in.	Copper Galv Iron Cast Iron Pipe at	$ 4.62
	Nipples	in. at	$
	Bushings	to in. at	$
	Red'g Inc'g	Couplings to in. at	$
	Union	in. at	$
	Meter	in. at	$
	Lead Joints at		$
	Leadite Joints at		$
	Hrs. Foreman at		$
1/2	Hrs. Chauffeur at		$ .31
1/2	Hrs. Tapper at		$ .31
8	Hrs. Labor at		$ 3.60
	Hrs. Labor at		$
	Hrs. Compressor at		$
	Compensation Ins.		$ .15
	Trucking		$ 1.–
	Builders Use of Water		$
			$
			$
			$
	Tap by Power		$
			$ 15.15

137-1937

St. ~~Pl.~~ Ave. No. 18 12½

Smith St.

Name of Owner

Miss M Winter

Labor and Mat'l. Report Oct. 8 1937

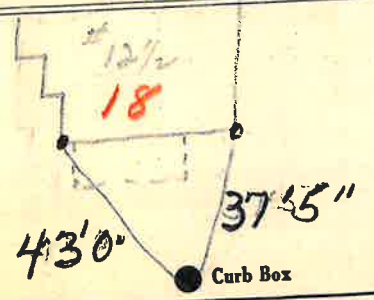

6 Main

Elev. of Main at tap 4½

Gate at

Gate at

21' to MAIN
3/4" COPPER

Curb Box

old Shut off

TAX ID # 302.16-5-7

Bill