Labor and Materials

1	Copper Lead — Connection	3/4	$ 1.41
1	Curb — Cock / Valve / T. S. & V.	3/4 in	$ 1.93
1	Service Box Old returned — Short 3½ x 4½ / Long 4½ x 5½ / Buff. or Rdway		$ 1.70
21	Ft. 3/4 in. — Copper / Galv Iron / Cast Iron — Pipe at		$ 4.62
	Nipples in. at		$
	Bushings to in. at		$
	Red'g Inc'g — Couplings to in. at		$
	Union in. at		$
	Meter in. at		$
	Lead Joints at		$
	Leadite Joints at		$
	Hrs. Foreman at		$
1/2	Hrs. Chauffeur at		$
1/2	Hrs. Tapper at		$ .31
3	Hrs. Labor at		$ .31
	Hrs. Labor at		$ 3.60
	Hrs. Compressor at		$
	Compensation Ins.		$
	Trucking		$ .15
	Builders Use of Water		$ 1.-
			$
			$
			$
	Tap by Hassel		$
			$ 15.15

1 3 8 - 1937

St. 22
Pl.
Ave. Smith No. 16

Name of Owner
Stanton

Labor and Mat'l. Report Oct 18 19 37

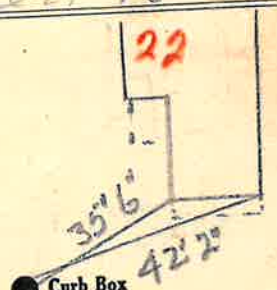

6 Main

Elev. of Main at tap 4½

Gate at • 21' to MAIN 3/4" COPPER • Gate at

• Curb Box

Old Shut off

TAX ID# 302.16-5-9

Bill