Labor and Materials

1	Copper Lead — Connection 3/4	$ 1.46
1	Curb — Cock / Valve / T. S. & V. 3/4 in	$ 1.93
1	Service Box — Old returned — Short 3½ x 4½ / Long 4½ x 5½ / Buff. or Rdway	$ 1.77
11	Ft. 3/4 in. — Copper / Galv Iron / Cast Iron — Pipe at	$ 2.42
	Nipples in. at	$
	Bushings to in. at	$
	Red'g / Inc'g — Couplings to in. at	$
	Union in. at	$
	Meter in. at	$
	Lead Joints at	$
	Leadite Joints at	$
	Hrs. Foreman at	$
½	Hrs. Chauffeur at	$ .31
½	Hrs. Tapper at	$ .31
8	Hrs. Labor at	$ 3.60
	Hrs. Labor at	$
	Hrs. Compressor at	$
	Compensation Ins.	$ .15
	Trucking	$ 1.~
	Builders Use of Water	$
		$
		$
		$
Tap hr Repair		$
1		$ 12.95

1 4 0 - 1937

St. Pl. Ave. Smith St No. 19 — 25

Name of Owner

G. F. Trust Co

Labor and Mat'l. Report Oct 18 19 37

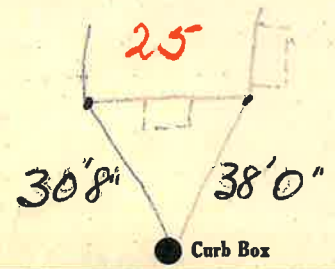

6 Main — Elev. of Main at tap 4½

Gate at • — • Gate at

11' to main
3/4" copper

• Curb Box

old shut off

TAX ID # 302.16-6-16

Bill