## Labor and Materials

| | | | |
|---|---|---|---|
| 1 | Copper / ~~Lead~~ Connection 3/4 | | $ 1.46 |
| 1 | Curb | Cock / Valve / T. S. & V. 3/4 in | $ 1.93 |
| 1 | Service Box Old returned | Short 3½ x 4½ / Long 4½ x 5½ / Buff. or Rdway | $ 1.77 |
| 21 | Ft. 3/4 in. | Copper / Galv Iron / Cast Iron Pipe at | $ 4.62 |
| | Nipples in. at | | $ |
| | Bushings to in. at | | $ |
| | Red'g / Inc'g Conplings to in. at | | $ |
| | Union in. at | | $ |
| | Meter in. at | | $ |
| | Lead Joints at | | $ |
| | Leadite Joints at | | $ |
| | Hrs. Foreman at | | $ |
| ½ | Hrs. Chauffeur at | | $ .31 |
| ½ | Hrs. Tapper at | | $ .31 |
| 8 | Hrs. Labor at | | $ 3.60 |
| | Hrs. Labor at | | $ |
| | Hrs. Compressor at | | $ |
| | Compensation Ins. | | $ .15 |
| | Trucking | | $ 1.– |
| | Builders Use of Water | | $ |
| | | | $ |
| | | | $ |
| | | | $ |
| | Tapby Pein | | $ |
| | | | $ 15.15 |

104-1937

Smith St. ~~Pl.~~ ~~Ave.~~ No. 26 20

Name of Owner

Bedsworth

Labor and Mat'l. Report Oct 18 19

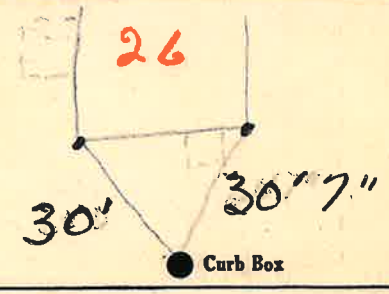


6 Main

Elev. of Main at tap 4½

Gate at 21' to MAIN 3/4" COPPER

Gate at

Curb Box

old Shut off

TAX ID# 302.16-5-11