Labor and Materials

1	Copper Lead — Connection	3/4	$ 1.46
1	Curb — Cock / Valve / T. S. & V.	3/4 in	$ 1.93
1	Service Box — Old returned — Short 3½ x 4½ / Long 4½ x 5½ / Buff or Rdway		$ 1.77
24	Ft. 3 in. — Copper / Galv Iron / Cast Iron — Pipe at		$ 4.84
	Nipples in. at		$
	Bushings to in. at		$
	Red'g / Inc'g — Couplings to in. at		$
	Union in. at		$
	Meter in. at		$
	Lead Joints at		$
	Leadite Joints at		$
	Hrs. Foreman at		$
1½	Hrs. Chauffeur at		$ .31
1½	Hrs. Tapper at		$ .31
8	Hrs. Labor at		$ 3.60
	Hrs. Labor at		$
	Hrs. Compressor at		$
	Compensation Ins.		$ .15
	Trucking		$ 1.—
	Builders Use of Water		$
			$
			$
			$
			$
			$ 15.37

13 1–1937

St. ~~Pl.~~ ~~Ave.~~ No. 8

Smith 4

Name of Owner

Mrs Adams

Labor and Mat'l. Report Oct 7 1937

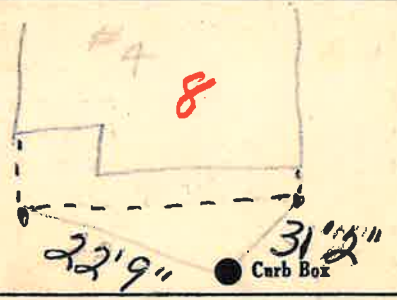

6" Main

Elev. of Main at tap 4½

Gate at • • Gate at

22' to main
3/4" copper

• Curb Box

old shut off

TAX ID# 302.16-5-2

Bill