Labor and Materials

1	Copper / Lead	Connection 3/4	$ 1.46
1	Curb	Cock / Valve / T. S. & V. 3/4 in	$ 1.93
1	Service Box / Old returned	Short 3½ x 4½ / Long 4½ x 5½ / Buff. or Rdway	$ 1.77
11	Ft. 3/4 in.	Copper / Galv Iron / Cast Iron Pipe at	$ 2.42
	Nipples	in. at	$
	Bushings	to in. at	$
	Red'g / Inc'g	Couplings to in. at	$
	Union	in. at	$
	Meter	in. at	$
	Lead Joints at		$
	Leadite Joints at		$
	Hrs. Foreman at		$
1/2	Hrs. Chauffeur at		$ .31
1/2	Hrs. Tapper at		$ .31
8	Hrs. Labor at		$ 3.60
	Hrs. Labor at		$
	Hrs. Compressor at		$
	Compensation Ins.		$ .15
	Trucking		$ 1 —
	Builders Use of Water		$
			$
			$
			$
	Typing Hand		$
			$ 12.95

141-

St. 27
Sam 13 St ~~Pl.~~ ~~Ave.~~ No. 21

Name of Owner
Salisbury

Labor and Mat'l. Report Oct 18 19

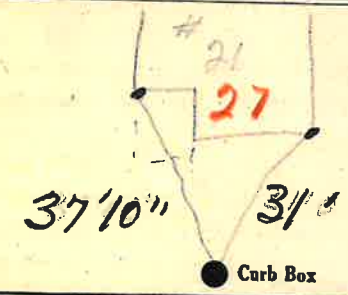

TAX ID # 302.16-6-15

6 Main

Elev. of Main at tap 4½

Gate at

11' to MAIN
3/4" COPPER

Gate at

Curb Box

Ad Shut off