Labor and Materials

1	Copper / ~~Lead~~ Connection	3/4	$ 1.46
1	Curb — Cock / Valve / T. S. & V.	3/4 in	$ 1.93
1	Service Box Old returned — ~~Short 3½ x 4½~~ / Long 4½ x 5½ / Buff. or Rdway		$ 1.77
21	Ft. ¾ in. — Copper / Galv. Iron / Cast Iron Pipe at		$ 1.62
	Nipples in. at		$
	Bushings to in. at		$
	Red'g / Inc'g Couplings to in. at		$
	Union in. at		$
	Meter in. at		$
	Lead Joints at		$
	Leadite Joints at		$
	Hrs. Foreman at		$
½	Hrs. Chauffeur at		$ .31
½	Hrs. Tapper at		$ .31
8	Hrs. Labor at		$ 3.60
	Hrs. Labor at		$
	Hrs. Compressor at		$
	Compensation Ins.		$ .15
	Trucking		$ 1.-
	Builders Use of Water		$
			$
			$
			$
	Tapping Machine		$
			$ 15.15

1 3 3 – 1937

St. 10
Pl.
South St Ave. No. 6

Name of Owner

Dillon

Labor and Mat'l. Report Oct 8 1937

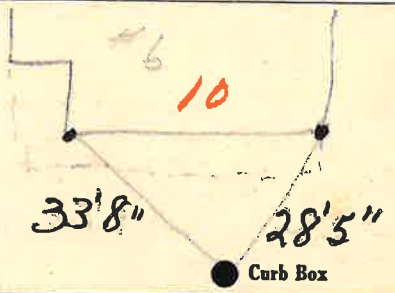

6 Main — Elev. of Main at tap 4½

Gate at • — • Gate at

21' to MAIN
3/4" COPPER

• Curb Box

old shut off

TAX ID # 302.16-5-3

Rec'd