Labor and Materials

1	Copper Lead — Connection	3/4	$ 1.46
1	Curb — Cock / Valve / T. S. & V.	3/4 in	$ 1.03
1	Service Box Old returned — Short 3½ x 4½ / Long 4½ x 5½ / Buff. or Rdway		$ 1.77
11	Ft. 3/4 in. — Copper / Galv Iron / Cast Iron — Pipe at		$ 2.42
	Nipples in. at		$
	Bushings to in. at		$
	Red'g Inc'g — Couplings to in. at		$
	Union in. at		$
	Meter in. at		$
	Lead Joints at		$
	Leadite Joints at		$
	Hrs. Foreman at		$
½	Hrs. Chauffeur at		$ .31
½	Hrs. Tapper at		$ .31
8	Hrs. Labor at		$ 3.60
	Hrs. Labor at		$
	Hrs. Compressor at		$
	Compensation Ins.		$ .15
	Trucking		$ 1.—
	Builders Use of Water		$
			$
			$
			$
			$
			$ 12.95

Tap & Bore

1 3 4 – 1937

St. 11
Pl.
South Ave. No. 7

Name of Owner

Simpson

Labor and Mat'l. Report Oct 5 19

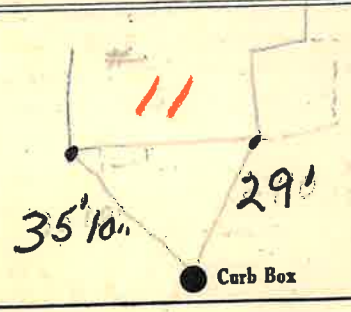

6 Main

Elev. of Main at tap 4½

Gate at • 11' to main 3/4" Copper

• Gate at

Curb Box

Will Shut Off

TAX ID# 302.16-6-22

Bill