Labor and Materials

1	Copper / ~~Lead~~ Connection 3/4	$ 1.46
1	Curb Cock / Valve / T. S. & V. 3/4 in	$ 1.93
1	Service Box Old returned Short 3½ x 4½ / Long 4½ x 5½ / Buff. or Rdway	$ 1.77
22	Ft. 3/4 in. Copper / Galv Iron / Cast Iron Pipe at	$ 1.84
	Nipples in. at	$
	Bushings to in. at	$
	Red'g / Inc'g Conplings to in. at	$
	Union in. at	$
	Meter in. at	$
	Lead Joints at	$
	Leadite Joints at	$
	Hrs. Foreman at	$
1/2	Hrs. Chauffeur at	$ .31
1/2	Hrs. Tapper at	$ .31
8	Hrs. Labor at	$ 3.60
	Hrs. Labor at	$
	Hrs. Compressor at	$
	Compensation Ins.	$ .15
	Trucking	$ 1.—
	Builders Use of Water	$
		$
		$
		$
	Tapping Reuse	$
		$ 15.37

135-1937

St. Pl. Ave. No. 10 — 14

Smith St

Name of Owner

Kipp

Labor and Mat'l. Report Oct 8 1937

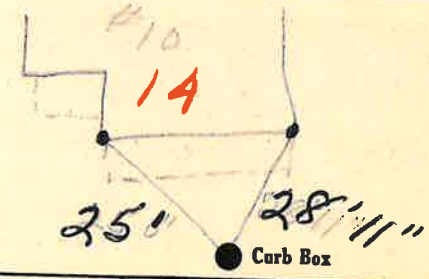

TAX ID # 302.16-5-5

6 Main — Elev. of Main at tap 4½

Gate at • — • Gate at

22' to main
3/4" Copper

Curb Box

old shut off

Bill