LABOR AND MATERIALS

1	Copper / ~~Lead~~ Connection 3/4"	$ 1.31
1	Curb { Cock / ~~Valve~~ / ~~T. S. & V.~~ } 3/4 in.	$ 1.75
1	Service Box / ~~Old returned~~ { Short 3½x4½ / ~~Long 4½x5½~~ / ~~Buff. or Rdway~~ }	$ 1.60
28 Ft. 3/4 in.	{ Copper / ~~Galv Iron~~ / ~~Cast Iron~~ } Pipe at 18	$ 5.04
	Nipples ____ in. at	$
	Bushings ____ to ____ in. at	$
	Red'g / Inc'g Couplings ____ to ____ in. at	$
	Union ____ in. at	$
	Meter ____ in. at	$
	Lead Joints at	$
	Leadite Joints at	$
	Hrs. Foreman at	$
2¼	Hrs. Chauffeur at 62½¢	$ 1.41
4¾	Hrs. Tapper at "	$ 2.97
19	Hrs. Labor at 45	$ 8.55
	Hrs. Labor at	$
	Hrs. Compressor at	$
	Compensation Ins.	$ .40
	Trucking	$ 1.—
	Builders Use of Water Napatch	$
		$
		$
		$
Tap by Hessel		$
		$ 24.03

3 1 - 1940

St.
~~Pl.~~
~~Ave.~~ No. 215

South

Name of Owner

West

Labor and Mat'l. Report SEP 2 4 1940 19

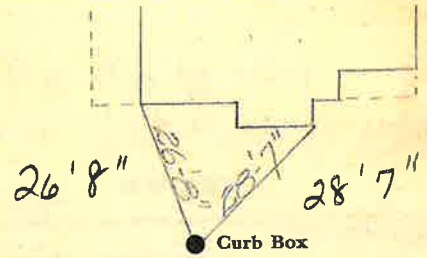

4" Main Fifth St. Elev. of Main at tap 5'

Gate at ● ● Gate at

28' to MAIN
3/4" COPPER

● Curb Box

TAX ID # 309.12-15-3

Old tap shut off.