LABOR AND MATERIALS

Copper / Lead } Connection ..... $.....

Curb { Clock / Valve / T. S. & V. } ..... in. ..... $.....

Service box / Old returned { Short 3⅛X4⅛ / Long 4⅛X5⅛ / Buff or Rdway } ..... $.....

.....Ft. ....in. { Copper / Galv. Iron / Cast Iron } Pipe at ..... $.....

.....Nipples ....in. at ..... $.....

.....Bushings.....to .....in. at ..... $.....

Red'g / Inc'g } Couplings..... to..... in. at..... $.....

.....Union ..... in. at ..... $.....

.....Meter.....in. at ..... $.....

.....Lead Joints at ..... $.....

.....Compound Joints at..... $.....

.....Hrs. Foreman at ..... $.....

.....Hrs. Chauffeur at ..... $.....

.....Hrs. Tapper at ..... $.....

.....Hrs. Labor at ..... $.....

.....Hrs. Labor at ..... $.....

.....Hrs. Compressor at ..... $.....

.....Compensation Ins. ..... $.....

.....Trucking ..... $.....

.....Builders Use of Water. ..... $.....

..... $.....

..... $.....

..... $.....

..... $.....

$.....

South St. / ~~Pl.~~ / ~~Ave.~~ No. 222

Name of Owner

TAX ID # 309.12-11-61

Labor and Mat'l. Report Aug 1945

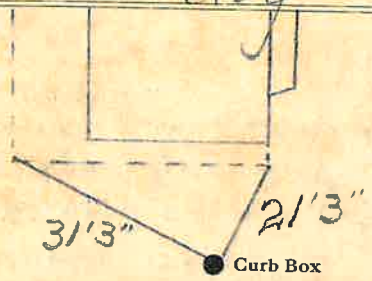

..... Main

Elev. of Main at tap.....

Gate at ●

● Gate at

● Curb Box

LSM-5C-6-1-45