## Labor and Materials

| | | | |
|---|---|---|---|
| 1 | Copper ~~Iron~~ Connection | 3/4 | $ 1.23 |
| 1 | Curb: Cock / ~~Valve~~ / T. S. & V. | 3/4 in | $ 1.68 |
| 1 | Service Box Old returned: ~~Short 3½ x 4½~~ / Long 4½ x 5½ / Buff. or Rdway | | $ 1.75 |
| 22 | Ft. 3/4 in. Copper / ~~Galvanized~~ / Cast Iron Pipe at .15 | | $ 3.00 |
| | Nipples in. at | | $ |
| | Bushings to in. at | | $ |
| 1 | ~~Red'g~~ / Inc'g Couplings 3/4" to 3/4 in. at Cop to Cop. 1961. | | $ |
| | Union in. at | | $ |
| | Meter in. at | | $ |
| | Lead Joints at | | $ |
| | Leadite Joints at | | $ |
| | Hrs. Foreman at | | $ |
| 4 | Hrs. Chauffeur at 62½ | | $ 2.50 |
| | Hrs. Tapper at | | $ |
| 4 | Hrs. Labor at .45 | | $ 1.80 |
| | Hrs. Labor at | | $ |
| | Hrs. Compressor at | | $ |
| | Compensation Ins. | | $ .14 |
| | Trucking | | $ 1.00 |
| | Builders Use of Water | | $ |
| Tap & Pour Patch | | | $ 5.00 |
| | | | $ |
| | | | $ |
| | | | $ 18.10 |

25 - 1938 232 South 1

St. / ~~Pl.~~ / ~~Ave.~~ South No. 232

**Name of Owner**

Mrs. Agnes Richards

**Labor and Mat'l. Report** 5-24-38 19

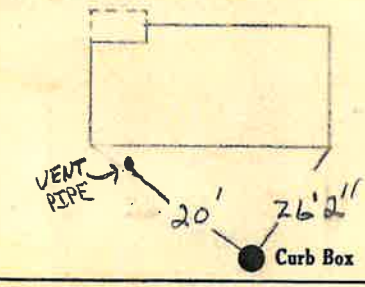


6 Main Water St. Elev. of Main at tap 6'

Gate at • • Gate at

22' to main
3/4" copper

• Curb Box

Old tap disconnected.

TAX ID # 309.12-11-65

BM