LABOR AND MATERIALS

1 Copper / ~~Lead~~	Connection 3/4	$ 1.31
1 Curb	Cock / ~~Valve~~ / T. S. & V. 3/4 in.	$ 1.75
1 Service Box Old returned	Short 3½x4½ / Long 4½x5½ / Buff. or Rdway	$ 1.60
24 Ft. 3/4 in.	Copper / Galv Iron / Cast Iron Pipe at 18	$ 4.32
____ Nipples	____ in. at	$ ____
____ Bushings	____ to ____ in. at	$ ____
Red'g / Inc'g Couplings	____ to ____ in. at	$ ____
____ Union	____ in. at	$ ____
____ Meter	____ in. at	$ ____
____ Lead Joints at		$ ____
____ Leadite Joints at		$ ____
____ Hrs. Foreman at		$ ____
11 Hrs. Chauffeur at	62½	$ 6.88
1 Hrs. Tapper at		$ 5.00
16 Hrs. Labor at	45	$ 7.20
____ Hrs. Labor at		$ ____
____ Hrs. Compressor at		$ ____
____ Compensation Ins.		$ .58
____ Trucking		$ 1.—
____ Builders Use of Water	½ Patch (Sewer)	$ 2.50
Tap & Tear		$ ____
		$ ____
		$ ____
		$ ____
		$ 32.14

B B - - 1940 237 South St.

South ~~Pl.~~ Ave. No. 237

Name of Owner

Carpenter

Labor and Mat'l. Report Cuy 5" 1940

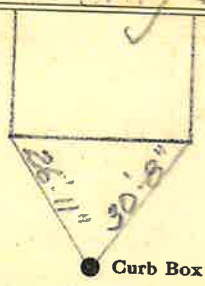

6" Main — Elev. of Main at tap 5"

Gate at ● ● Gate at

24' to MAIN
3/4" COPPER

● Curb Box

TAX ID# 309.16-2-2