LABOR AND MATERIALS

1	Copper / ~~Lead~~ Connection	3/4	$ 2.87
1	Curb ~~Cock~~ / ~~Valve~~ / ~~T. S. & V.~~	3/4 in.	$ 3.62
1	Service box Old returned ~~Short 3½X4½~~ / ~~Long 4½X5½~~ / ~~Buff or Rdway~~		$ 4.68
10	Ft. 3/4 in. ~~Copper~~ / ~~G. I.~~ / ~~C. I.~~ Pipe at 32		$ 3.20
	Nipples ... in. at		$
	Bushings ... to ... in. at		$
	~~Red'g~~ / ~~Inc'g~~ Coupl'gs ... to ... in. at		$
	Union ... in. at		$
	Meter ... in. at		$
	Lead Joints at		$
	Compound Joints at		$
	Hrs. Water Maint. Man—1 at		$
3	Hrs. Water Maint. Man—2 at 1.02		$ 3.06
12	Hrs. Labor— at 91		$ 10.92
	Hrs. Labor— at		$
	Hrs. Compressor at		$
	Compensation Ins. at $ 2.18 per C		$ .30
	Trucking		$ 2.00
	Pav't Patch		$ 10.25
	Tap by Myrum		$
			$
			$
	O'head		$
			$ 40.80

108 240 South

St.
~~Pl.~~
Ave. No. 240

South

Name of Owner

Vincent

Labor and Mat'l. Report Oct 29 1947

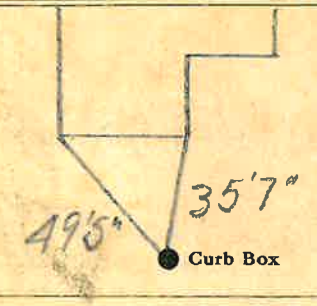

6 Main

Elev. of Main at tap 5

Gate at ● ● Gate at

10' to main
3/4" copper

● Curb Box

Curb Box 1½' deep

TAX ID # 309.16.8-15

LSM-5C 5 15-48