Labor and Materials

1	Copper / ~~Lead~~ Connection 3/4	$ 2.60
1	Curb { Cock / ~~Valve~~ / ~~T. S. & V.~~ } 3/4 in.	$ 2.27
1	Service Box Old returned { Short 3½x4½ / ~~Long 4½x5½~~ / ~~Buff. or Rdway~~ }	$ 1.28
25 ~~22~~	Ft. 3/4 in. { Copper / Galv. Iron / Cast Iron } Pipe at	$ 4.14
	Nipples ..... in. at	$
	Bushings ..... to ..... in. at	$
	Red'g / Inc'g } Couplings ..... to ..... in. at	$
	Union ..... in. at	$
	Meter ..... in. at	$
	Lbs. Br. Stone at	$
	Lbs. Sand at	$
	Bags Cement at	$
	Paving Brick { Mack / Red / Asphalt } at	$
	Lead Joints at	$
	Leadite Joints at	$
5	Hrs. Foreman at	$ 3.13
2	Hrs. ~~Common Labor~~ at Tapper	$ 1.—
12	Hrs. Common Labor at	$ 5.40
	Hrs Mason at	$
	Hrs Mason's Helper at	$
1½	Hrs. Compressor at	$ 1.50
	Compensation Ins	$ .29
	Trucking	$ 1.—
	Builders' Use of Water Patch	$ 23.—
	Total	$ 45.71

135 SOUTH

Labor and Material Report July 15 1931

3/4 tap at 135 South

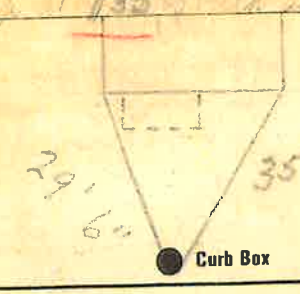

10" Main

Elev of Main at tap 611

Gate at ● 25' to MAIN ● Gate at

3/4" COPPER

● Curb Box

Old tap shut off

Curb box set back.

2' — 1962

TAX ID# 309.35-5-4