Labor and Materials

Copper / Lead } Connection ..... $.....

Curb { Cock / Valve / T. S. & V. } ..... in ..... $.....

Service Box / Old returned { Short 3½ x 4½ / Long 4½ x 5½ / Buff. or Rdway } ..... $.....

.....Ft. .....in. { Copper / Galv Iron / Cast Iron } Pipe at ..... $.....

..... Nipples ..... in. at ..... $.....

.....Bushings ..... to ..... in. at ..... $.....

Red'g / Inc'g { Couplings ..... to ..... in. at ..... $.....

.....Union ..... in. at ..... $.....

.....Meter ..... in. at ..... $.....

.....Lead Joints at ..... $.....

.....Leadite Joints at ..... $.....

.....Hrs. Foreman at ..... $.....

.....Hrs. Chauffeur at ..... $.....

.....Hrs. Tapper at ..... $.....

.....Hrs. Labor at ..... $.....

.....Hrs. Labor at ..... $.....

.....Hrs. Compressor at ..... $.....

.....Compensation Ins. ..... $.....

.....Trucking ..... $.....

.....Builders Use of Water ..... $.....

..... $.....

..... $.....

..... $.....

..... $.....

$.....

162 20th St. / ~~Pl.~~ / ~~Ave.~~ South No. 162

Name of Owner

TAX ID# 309.12-11-17

Labor and Mat'l. Report 19

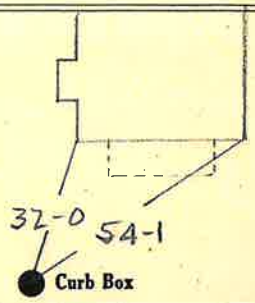

.....Main

Elev. of Main at tap..... ....

Gate at •

• Gate at

• Curb Box

5/19/05 New 3/4" K"
From Box to House