LABOR AND MATERIALS

1	Copper / ~~Lead~~ Connection	1"	$ 4.48
1	Curb — Cock / ~~Valve~~ / ~~T. S. & V.~~	1" in.	$ 5.58
1	Service box — Old returned — Short 3½X4½ / ~~Long 4½X5½~~ / Buff or Rdway		$ 5.90
11	Ft. 1" in. — Copper / ~~G. I.~~ / C. I. — Pipe at 41		$ 4.51
	Nipples ... in. at		$
	Bushings ... to ... in. at		$
	Red'g / Inc'g Coupl'gs ... to ... in. at		$
	Union ... in. at		$
	Meter ... in. at		$
1	~~Lead Joints~~ at 1" Adaptor		$ .87
	Compound Joints at		$
	Hrs. Water Maint. Man—1 at		$
7	Hrs. Water Maint. Man—2 at	1.02	$ 7.14
21	Hrs. Labor— at	.91	$ 19.11
	Hrs. Labor— at		$
2	Hrs. Compressor at	1.20	$ 2.40
	Compensation Ins. at $ ... per C		$ .58
	Trucking		$ 1.00
	Pav't Patch		$ 2.30
Tap by Marshall's Crew			$
			$
			$
	O'head		$
			$ 59.87

150

St. 1 Pl. Ave. No. 180

Name of Owner

Rourdon & Bush

Labor and Mat'l. Report Nov 3 19 48

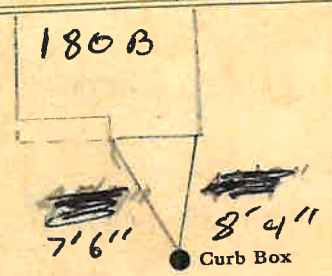

6 Main

Elev. of Main at tap 4½

Gate at ● ● Gate at

11' to MAIN
1" COPPER

● Curb Box

TAX ID # 309.12-11-36

1" Top ... for 2 Horses ... Road

LSM-5C 5 15-48