LABOR AND MATERIALS

1	Copper ~~Lead~~ Connection	3/4	$2.94
1	Curb { Clock ~~Valve~~ ~~T. S. & V.~~ }	3/4 in.	$3.71
1	Service box ~~Old returned~~ { Short 3½X4½ Long 4½X5½ Buff or Rdway }	Some	$ —
26	Ft. 3/4 in. { Copper ~~Galv. Iron~~ ~~Cast Iron~~ }	Pipe at 30	$7.80
	Nipples in. at		$
	Bushings to in. at		$
	Red'g Inc'g } Couplings to in. at		$
	Union in. at		$
	Meter in. at		$
	Lead Joints at		$
	Compound Joints at		$
3	Hrs. ~~Foreman at~~ WMM-1	1.01	$3.03
9	Hrs. ~~Chauffeur at~~ WMM-2	91	$8.19
	Hrs. Tapper at		$
14	Hrs. Labor at	80	$11.20
	Hrs. Labor at		$
2	Hrs. Compressor at	1.20	$2.90
	Compensation Ins.		$ .49
	Trucking		$ 1.00
	Builders Use of Water		$ ~~8.00~~
	Tapping 1 1/2 ag [illegible]		$
			$
			$
			$
			$48.76

11

St. ~~Pl.~~ ~~Ave.~~ No. 12

Spring

Name of Owner

Hilderbrant

Labor and Mat'l. Report Apr 9 1948

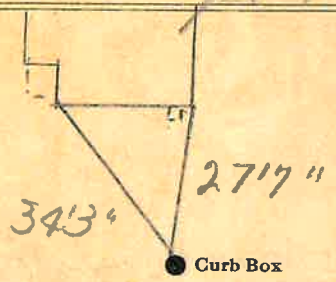

4 Main

Elev. of Main at tap 6

Gate at ● ● Gate at

26' to main

3/4" copper ● Curb Box

TAX ID # 309.35-4-2

LSM-5C-6-1-45