Labor and Materials

	Lead Connection	$
1	Curb Cock	$
1	Service Box (Short 3½ x 4½ / Long 4½ x 6½ / Buffalo) Old returned	$
10	Ft. 3 in. ~~G.I.~~ Cu Pipe at	$
	Nipples in. at	$
	Bushings to in. at	$
	Red'g Coup to in. at	$
	Inc'g Coup to in. at	$
	Union in. at	$
	Meter in. at	$
	Cu. Yds. Br. Stone at	$
	Cu. Yds. Sand at	$
	Bags Cement at	$
	Paving Brick (Mack / Red / Asphalt) at	$
	Hrs. Foreman at	$
	Hrs. Common Labor at	$
	Hrs. Mason at	$
	Hrs. at	$
	Hrs. at	$
	Builders' Use of Water	$
	at	$
	at	$
	at	$
	at	$
	Total	$

Labor and Material Report July 1 19 78

no 58 Stofle st

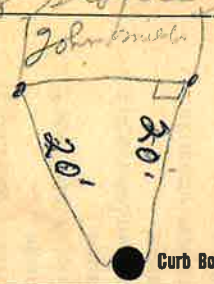

¼ Main

Elev. of Main at tap 4'

Gate at ● ● Gate at

10' to main

3/4" copper ● Curb Box