## Labor and Materials

1 ~~Lead~~ Connection 3/4 ..... $.....

1 Curb Cock 3/4 ..... $.....

1 Service Box ~~Old returned~~ { Short 3½ x 4½ / ~~Long 4½ x 5½~~ / Buffalo } $.....

20 Ft. 3/4 in. ~~G. I.~~ copper Pipe at ..... $.....

..... Nipples ..... in. at ..... $.....

..... Bushings ..... to ..... in. at ..... $.....

..... Red'g Coup ..... to ..... in. at ..... $.....

..... Inc'g Coup ..... to ..... in. at ..... $.....

..... Union ..... in. at ..... $.....

..... Meter ..... in. at ..... $.....

..... Cu. Yds. Br. Stone at ..... $.....

..... Cu. Yds. Sand at ..... $.....

..... Bags Cement at ..... $.....

..... Paving Brick { Mack / Red / Asphalt } at ..... $.....

..... Hrs. Foreman at ..... $.....

..... Hrs. Common Labor at ..... $.....

..... Hrs. Mason at ..... $.....

..... Hrs. ..... at ..... $.....

..... Hrs. ..... at ..... $.....

..... Builders' Use of Water ..... $.....

..... at ..... $.....

..... at ..... $.....

..... at ..... $.....

..... at ..... $.....

Total $.....

## Labor and Material Report July 11 1938

no 59 Staple st.

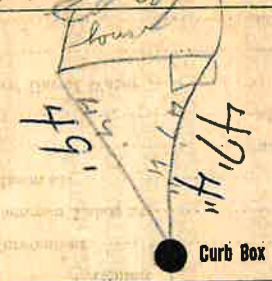


6" Main

Elev. of Main at tap 4'

Gate at ● ● Gate at

20' to main
3/4" copper

Curb Box

measurement from
58 Staple st.