Labor and Materials

1 Copper ~~Lead~~ Connection ..... $.....

1 Curb Cock ..... $.....

~~Service Box~~ ~~Old returned~~ { ~~Short 3½ x 4½~~ Long 4½ x 5½ ~~Buffalo~~ } $.....

8 Ft. ¾ in. ~~G. I.~~ Copper Pipe at ..... $.....

Nipples ..... in. at ..... $.....

Bushings ..... to ..... in. at ..... $.....

Red'g Coup .... to .... in. at ..... $.....

Inc'g Coup .... to .... in. at ..... $.....

Union .... in. at ..... $.....

Meter .... in. at ..... $.....

Cu. Yds. Br. Stone at ..... $.....

Cu. Yds. Sand at ..... $.....

Bags Cement at ..... $.....

Paving Brick { Mack / Red / Asphalt } at ..... $.....

Hrs. Foreman at ..... $.....

2 Hrs. Common Labor at ..... $.....

Hrs. Mason at ..... $.....

Hrs. ..... at ..... $.....

Hrs. ..... at ..... $.....

Inv. Builders' Use of Water ..... $.....

..... at ..... $.....

Truck 100 ..... at ..... $.....

..... at ..... $.....

..... at ..... $.....

Total $.....

East

Labor and Material Report

Sept 5 1925

27 State St.

~~West~~

Void

See below

P. Kelly

Was

Now John Kemnitzer.

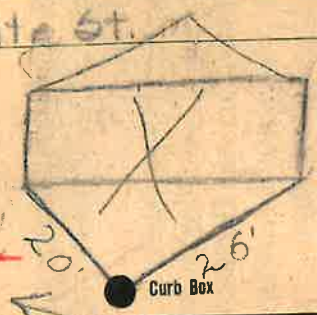

Main

Elev. of Main at tap

Gate at

Gate at

TAX ID# 309.16-22-3.1

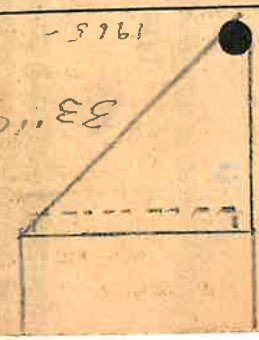

¾" Copper 8' to main