LABOR AND MATERIALS

1	Copper Lead. Connection	3/4	$ 2.94
1	Curb { Clock Valve T. S. & V. }	3/4 in.	$ 3.71
1	Service box Old returned { Short 3½X4½ Long 4½X5½ Buff or Rdway }		$ 5.90
10	Ft. 3/4 in. { Copper Galv. Iron Cast Iron } Pipe at 30		$ 3.00
	Nipples in. at		$
	Bushings to in. at		$
	Red'g Inc'g } Couplings to in. at		$
	Union in. at		$
	Meter in. at		$
	Lead Joints at		$
	Compound Joints at		$
4	Hrs. ~~Foreman~~ at WM.M.-1	101	$ 4.04
3	Hrs. ~~Chauffeur~~ at — 2	91	$ 2.73
	Hrs. Tapper at		$
4	Hrs. Labor at	80	$ 3.20
	Hrs. Labor at		$
	Hrs. Compressor at		$ .22
	Compensation Ins.		$ 1.—
	Trucking		$
	Builders Use of Water		$
	Tap by Water Dept.		$
			$
			$
			$ 26.74

18

East St. 37 St. Pl. Ave. No. 4

Name of Owner

Leo Blair

Labor and Mat'l. Report April 12 1945

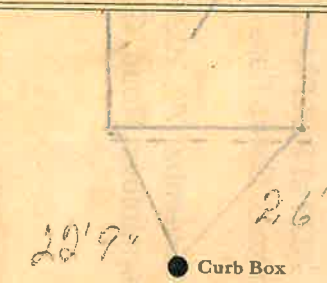

6 Main

Elev. of Main at tap 5"

Gate at ● ● Gate at

3/4" Copper 10' to main

● Curb Box

TAX ID # 309.16-22-1

LSM-5C-6-1-45