LABOR AND MATERIALS

3/4 ~~Copper~~ ~~Lead~~ } Connection ..... $.....

..... Curb { Cock / Valve / T. S. & V. } ..... in. ..... $.....

..... Service box { Short 3½ x 4½ / Long 4½ x 5½ } Old returned ..... $.....

..... Ft. 3/4 in. { Copper / ~~G. I.~~ / ~~C. I.~~ } Pipe at ..... $.....

..... Nipples ..... in. at ..... $.....

..... Bushings ..... to ..... in. at ..... $.....

..... { Red'g / Inc'g } Coupl'gs ..... to ..... in. at ..... $.....

..... Union ..... in. at ..... $.....

..... Meter ..... in. at ..... $.....

.... $.....

..... Compound Joints at ..... $.....

..... Maintenance Foreman ..... $.....

..... Hrs. Water Maint. Man—1 at ..... $.....

..... Hrs. Water Maint. Man—2 at ..... $.....

..... Hrs. Garage Foreman ..... at ..... $.....

..... Hrs. Labor— ..... at ..... $.....

..... Hrs. Compressor at ..... $.....

..... $.....

..... Trucking ..... $.....

..... Pav't Patch ..... $.....

..... $.....

..... $.....

..... $.....

.... $.....

$ 255.—

8 E. State (St.) Pl. Ave. No. 8

Name of Owner

TAX ID# 309.16-17-20

Labor and Mat'l. Report 10/31 1996

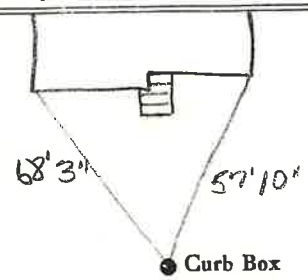

..... Main Elev. of Main at tap .....

Gate at • • Gate at

....

• Curb Box

3/4" copper

LSM—5C—6-1-67