Labor and Materials

1	Cop.	~~Lead~~ Connection	$
1		Curb Cock	$
1		~~Service Box~~ / ~~Old returned~~ — Short 3½ x 4½ / Long 4½ x 5½ / ~~Buffalo~~	$
26	3/4"	~~Ft.~~ ~~in.~~ ~~C. I.~~ Pipe at Cop.	$
		Nipples ... in. at	$
		Bushings ... to ... in. at	$
		Red'g Coup ... to ... in. at	$
		Inc'g Coup ... to ... in. at	$
		Union ... in. at	$
		Meter ... in. at	$
		Cu. Yds. Br. Stone at	$
		Cu. Yds. Sand at	$
		Bags Cement at	$
		Paving Brick — Mack / Red / Asphalt — at	$
		Hrs. Foreman at	$
2		Hrs. Common Labor at	$
		Hrs. Mason at	$
		Hrs. ... at	$
		Hrs. ... at	$
One		Builders' Use of Water	$
		... at	$
		... at	$
	Truck 1.00	... at	$
		... at	$
		Total	$ 1.46

Labor and Material Report

Cuts 1925

32 Harding — 9 STATE ST

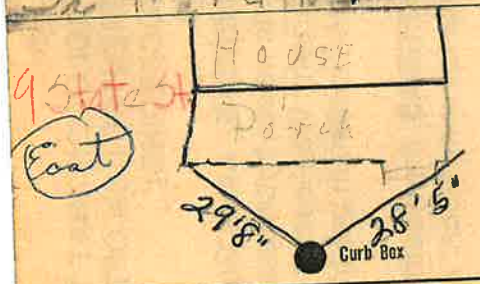

Main

Elev. of Main at tap

Gate at 3/4"
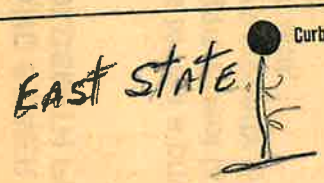
Gate at 26' to MAIN