Labor and Materials

Copper / Lead } Connection ..... $.....

Curb { Cock / Valve / T. S. & V. } ..... in ..... $.....

Service Box / Old returned { Short 3½ x 4½ / Long 4½ x 5½ / Buff. or Rdway } ..... $.....

..... Ft. ..... in. { Copper / Galv Iron / Cast Iron } Pipe at ..... $.....

..... Nipples ..... in. at ..... $.....

..... Bushings ..... to ..... in. at ..... $.....

Red'g / Inc'g } Couplings ..... to ..... in. at ..... $.....

..... Union ..... in. at ..... $.....

..... Meter ..... in. at ..... $.....

..... Lead Joints at ..... $.....

..... Leadite Joints at ..... $.....

..... Hrs. Foreman at ..... $.....

..... Hrs. Chauffeur at ..... $.....

..... Hrs. Tapper at ..... $.....

..... Hrs. Labor at ..... $.....

..... Hrs. Labor at ..... $.....

..... Hrs. Compressor at ..... $.....

..... Compensation Ins. ..... $.....

..... Trucking ..... $.....

..... Builders Use of Water ..... $.....

..... $.....

..... $.....

..... $.....

..... $.....

$.....

State St. ~~Pl.~~ Ave. No. .....

Name of Owner

Labor and Mat'l. Report April 13-38 19

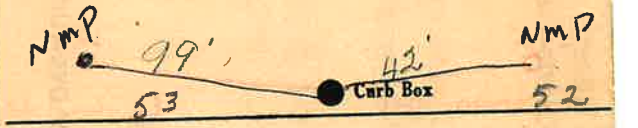

..... Main

Elev. of Main at tap ....

Gate at •

• Gate at

● Curb Box

vacant lot on state street