## Labor and Materials

1 Lead Connection 3/4" $

1 Curb Cock 1" $

1 Service Box { Short 3½ x 4½ / ~~Long 4½ x 6~~ / ~~Buffalo~~ } Old returned $

9 Ft. 1" in. G. I. Pipe at 1 $

Nipples in. at $

Bushings to in. at $

Red'g Coup to in. at $

Inc'g Coup to in. at $

Union in. at $

Meter in. at $

Cu. Yds. Br. Stone at $

Cu. Yds. Sand at $

Bags Cement at $

Paving Brick { Mack / Red / Asphalt } at $

2 Hrs. Foreman at $

2 Hrs. Common Labor at $

Hrs. Mason at $

Hrs. at $

Hrs. at $

2 hr Builders' Use of Water $

at $

Truck 100 at $

at $

at $

Total $ 9.37

---

Labor and Material Report Apr 30 1975

12 Stations S/S Renewal

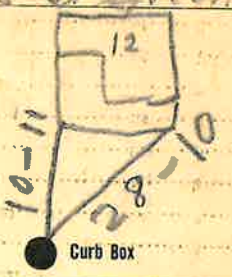


H Main Elev. of Main at tap H

Gate at 3/4" LEAD 9' to MAIN Gate at

Curb Box

TAX ID # 309.7-6-20