Labor and Materials

1 Copper / Lead } Connection 1/2" ..... $

1 Curb { Cock / Valve / T. S. & V. } 5/8 in ..... $

1 Service Box { Short 3½ x 4½ / Long 4½ x 5½ / Buff. or Rdway } Old returned ..... $

3 Ft. 3/4 in. { Copper / Galv Iron / Cast Iron } Pipe at ..... $

Nipples ..... in. at ..... $

Bushings ..... to ..... in. at ..... $

Red'g / Inc'g { Couplings ..... to ..... in. at ..... $

Union ..... in. at ..... $

Meter ..... in. at ..... $

Lead Joints at ..... $

Leadite Joints at ..... $

Hrs. Foreman at ..... $

Hrs. Chauffeur at ..... $

Hrs. Tapper at ..... $

Hrs. Labor at ..... $

Hrs. Labor at ..... $

Hrs. Compressor at ..... $

Compensation Ins. ..... $

Trucking ..... $

Builders Use of Water ..... $

..... $

..... $

..... $

..... $

$

St. ~~Pl.~~ ~~Ave.~~ Stevens No. 20

Name of Owner

TAX ID # 309.7-6-24

Labor and Mat'l. Report 12-3-17 19

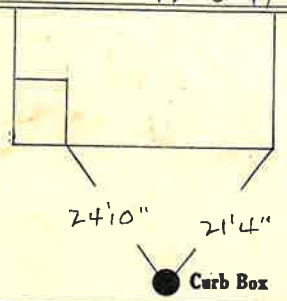

4 Main Elev. of Main at tap .....

Gate at ● 1/2 LEAD

● Gate at 3' to MAIN

● Curb Box