LABOR AND MATERIALS

1	Copper Lead { Connection 3/4"	$ 2.76
1	Curb { Cock ~~Valve~~ ~~T. S. & V.~~ } 3/4 in.	$ 3.99
1	Service box Old returned { Short 3½X4½ ~~Long 4½X5½~~ ~~Buff or Rdway~~ }	$ 4.74
16 Ft.	3/4 in. { Copper ~~C. I.~~ ~~C. I.~~ } Pipe at 38	$ 6.08
	Nipples ..... in. at	$
	Bushings ..... to ..... in. at	$
	Red'g Inc'g { Coupl'gs ..... to ..... in. at	$
	Union ..... in. at	$
	Meter ..... in. at	$
	Lead Joints at	$ 24.28
	Compound Joints at	$
5	Hrs. Water Maint. Man—1 at	$
5	Hrs. Water Maint. Man—2 at 1.24	$ 6.20
16	Hrs. Labor— ....at 1.13	$ 18.08
	Hrs. Labor— ....at	$
	Hrs. Compressor at	$
	Compensation Ins. at $ 4.06 per C	$ 1.07
	Trucking	$
	Pav't Patch	$ 12.60
Tap by Gifford 4-29-53		$
		$
		$
	O'head	$
		$ 56.02

43.62

29-53

St. ~~Pl.~~ Ave. No. 3

Stevens

Name of Owner

McGarr

Labor and Mat'l. Report Apr. 29 1953

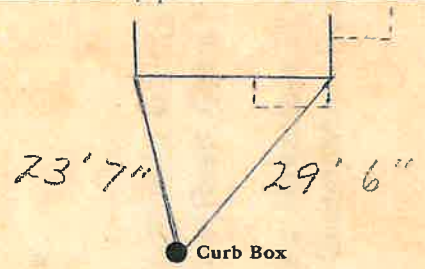

4" Main

Elev. of Main at tap 4½'

Gate at ● ● Gate at

3/4" Copper 16' to MAIN

● Curb Box

TAX ID# 309.7-5-7

L8M-5C 8 15-48