Labor and Materials

1 Copper Lead { Connection 1/2" ..... $

1 Curb { Cock Valve, T. S. & V. } 5/8 in ..... $

1 Service Box { Short 3½ x 4½ / Long 4½ x 5½ / Buff. or Rdway } ..... $

Old returned

18 Ft. 3/4 in. { Copper / Galv Iron / Cast Iron } Pipe at ..... $

..... Nipples ..... in. at ..... $

..... Bushings ..... to ..... in. at ..... $

..... Red'g / Inc'g { Couplings ..... to ..... in. at ..... $

..... Union ..... in. at ..... $

..... Meter ..... in. at ..... $

..... Lead Joints at ..... $

..... Leadite Joints at ..... $

..... Hrs. Foreman at ..... $

..... Hrs. Chauffeur at ..... $

..... Hrs. Tapper at ..... $

..... Hrs. Labor at ..... $

..... Hrs. Labor at ..... $

..... Hrs. Compressor at ..... $

..... Compensation Ins. ..... $

..... Trucking ..... $

..... Builders Use of Water ..... $

..... $

..... $

..... $

..... $

$

St. ~~Pl.~~ ~~Ave.~~ Stevens No. 5

Name of Owner

TAX ID # 309.7-5-6

Labor and Mat'l. Report 10-12-17 19

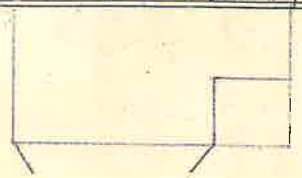

● Curb Box

4" Main

Elev. of Main at tap .....

Gate at ● 1/2" LEAD

● Gate at 18' to MAIN

● Curb Box