Labor and Materials

1 ~~Copper~~ Lead } Connection 1/2 ..... $.....

1 Curb { Cock / ~~Valve~~ / T. S. & V. } 5/8 in ..... $.....

1 Service Box { Short 3½ x 4½ / Long 4½ x 5½ / Buff. or Rdway } ..... $.....
Old returned

18 Ft. 3/4 in. { Copper / Galv Iron / Cast Iron } Pipe at ..... $.....

..... Nipples ..... in. at ..... $.....

..... Bushings ..... to ..... in. at ..... $.....

Red'g / Inc'g } Couplings ..... to ..... in. at ..... $.....

..... Union ..... in. at ..... $.....

..... Meter ..... in. at ..... $.....

..... Lead Joints at ..... $.....

..... Leadite Joints at ..... $.....

..... Hrs. Foreman at ..... $.....

..... Hrs. Chauffeur at ..... $.....

..... Hrs. Tapper at ..... $.....

..... Hrs. Labor at ..... $.....

..... Hrs. Labor at ..... $.....

..... Hrs. Compressor at ..... $.....

..... Compensation Ins. ..... $.....

..... Trucking ..... $.....

..... Builders Use of Water ..... $.....

..... $.....

..... $.....

..... $.....

..... $.....

$.....

Stevens St. Pl. Ave. No. 7

Name of Owner
Smith

Labor and Mat'l. Report 6-10-18 19

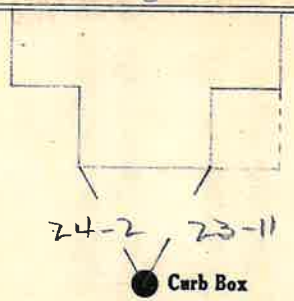

TAX FD # 309.7-5-5

4 Main

Elev. of Main at tap ....

Gate at ● 1/2 LEAD

● Gate at 18' to MAIN

● Curb Box