LABOR AND MATERIALS

1	Copper / ~~Lead~~	Connection	3/4	$ 2.87
1	Curb	Cock / ~~Valve~~ / ~~T. S. & V.~~	3/4 in.	$ 3.62
1	Service box Old returned	Short 3½X4½ / ~~Long 4½X5½~~ / ~~Buff or Rdway~~		$ 4.68
9	Ft. 3/4 in.	Copper / ~~G. I.~~ / ~~C. I.~~	Pipe at 32	$ 2.89
	Nipples ..... in. at			$
	Bushings ..... to ..... in. at			$
	Red'g Inc'g	Coupl'gs ..... to ..... in. at		$
	Union ..... in. at			$
	Meter ..... in. at			$
	Lead Joints at			$
	Compound Joints at			$
	Hrs. Water Maint. Man—1 at			$
2	Hrs. Water Maint. Man—2 at	1.02		$ 2.04
7	Hrs. Labor— ....at	91		$ 6.37
	Hrs. Labor— ....at			$
	Hrs. Compressor at			$
	Compensation Ins. at $ 2.18 per C			$ .18
	Trucking			$ 3.00
	Pav't Patch			$ 10.25
Tap by Miller				$
				$
				$
	O'head			$
				$ 34.89

83

St. ~~Pl.~~ Stewart Ave. No. 15

Name of Owner

Cohen

Labor and Mat'l. Report Aug 2 1949

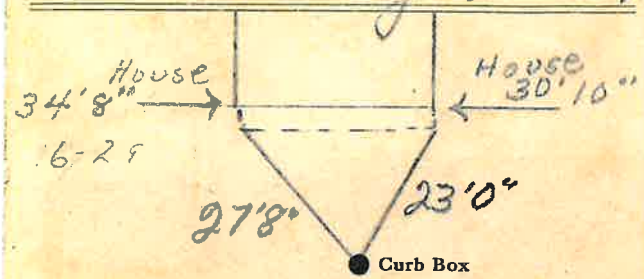

6 Main — Elev. of Main at tap 4½

Gate at ● ● Gate at

¾" Copper 9' to MAIN

● Curb Box

TAX ID# 309.11-15-18

LSM-SC B 15-48