Labor and Materials

1	Lead Connection	$ 2.69
1	Curb Cock	$ 1.76
1	Service Box { Short 3½ x 4½ / Old returned { ~~Long 4½ x 6½~~ / Buffalo	$ 1.29
24	Ft. 1 in. G. I. Pipe at	$ 4.68
	Nipples ..... in. at	$
	Bushings ..... to ..... in. at	$
	Red'g Coup .... to .... in. at	$
	Inc'g Coup .... to .... in. at	$
	Union .... in. at	$
	Meter .... in. at	$
	Cu. Yds. Br. Stone at	$
	Cu. Yds. Sand at	$
	Bags Cement at	$
	Paving Brick { Mack / Red / Asphalt } at	$
2	Hrs. Foreman at	$ 1.25
11	Hrs. Common Labor at	$ 4.47
	Hrs. Mason at	$
	Hrs. ..... at	$
	Hrs. ..... at	$
	Builders' Use of Water	$ 1.50
	Trucking at	$ 1.00
	Comp Hrs at	$ 1.5
	at	$
	at	$
	Total	$ 18.79

Labor and Material Report 19

28

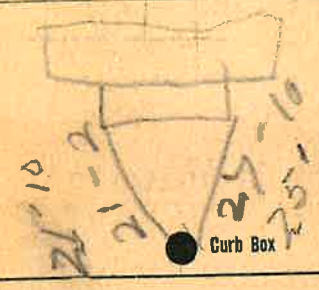

6 Main

Elev. of Main at tap 42

Gate at 3/4" LEAD

Gate at 24' to MAIN

Curb Box

TAX ID # 309.15-3-2