LABOR AND MATERIALS

1	Copper / ~~Lead~~ Connection 3/4	$ 2.51
1	Curb { Clock / Valve / ~~T. S. & V.~~ } 3/4 in.	$ 3.19
1	Service box / Old returned { Short 3½X4½ / Long 4½X5½ / Buff or Rdway }	$ 5.80
8	Ft. 3/4 in. { Copper / ~~Galv. Iron~~ / ~~Cast Iron~~ } Pipe at 35	$ 2.80
	Nipples in. at	$
	Bushings to in. at	$
	Red'g / Inc'g Couplings to in. at	$
	Union in. at	$
	Meter in. at	$
	Lead Joints at	$
	Compound Joints at	$
1	Hrs. ~~Foreman at~~ WMM 1.01	$ 1.01
	Hrs. Chauffeur at	$
	Hrs. Tapper at	$
	Hrs. Labor at	$
	Hrs. Labor at	$
	Hrs. Compressor at	$
	Compensation Ins.	$ .02
	Trucking	$ 1.00
	Builders Use of Water	$
	Tapping Mills	$
		$
		$
		$
		$ 16.33

44-47
1

Stewart St. / Pl. / Ave. No. 33

Name of Owner

C.W. Hall

Labor and Mat'l. Report July 19 1947

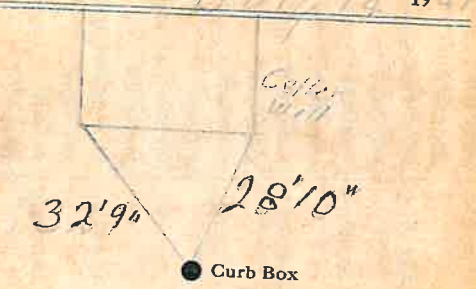

6 Main

Elev. of Main at tap 5

Gate at

Gate at

3/4" copper 8' to main

Curb Box

TAX ID# 309.11-15-11

LSM-5C-6-1-45