LABOR AND MATERIALS

1	Copper / ~~Lead~~ Connection 3/4"	$ 2.76
1	Curb { Cock / ~~Valve~~ / ~~T. S. & V.~~ } 3/4 in.	$ 3.49
Same	Service box { Short 3½X4½ / ~~Long 4½X5½~~ / ~~Buff or Rdway~~ }	$ —
8	Ft. 3/4 in. { Copper / ~~C. I.~~ / ~~C. I.~~ } Pipe at 38	$ 3.04
	Nipples ..... in. at	$
	Bushings ..... to ..... in. at	$
	Red'g / Inc'g Coupl'gs ..... to ..... in. at	$
	Union ..... in. at	$
	Meter ..... in. at	$
	Lead Joints at	$
	Compound Joints at	$
	Hrs. Water Maint. Man—1 at	$ 36.13
10	Hrs. Water Maint. Man—2 at 1.24	$ 12.48
21	Hrs. Labor— ....at 1.13	$ 23.73
	Hrs. Labor— ....at	$
	Hrs. Compressor at	$
	Compensation Ins. at $ 4.06 per C	$ 1.59
	Trucking	$ 1.00
	Pav't Patch	$ 5.40
Tap by Gissord 8-24-53		$
		$
		$
	O'head	$
		$ 53.41

4801

St. / Pl. / Ave. No. 19

Stoddard

Name of Owner

Hewitt

Labor and Mat'l. Report Aug. 24, 1953

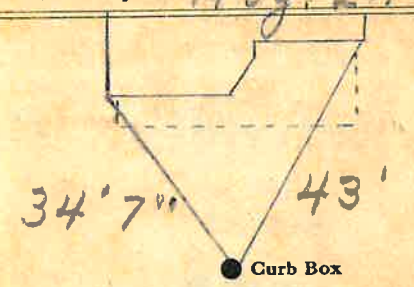

6" Main

Elev. of Main at tap 5½'

Gate at ●

● Gate at

3/4" copper 8' to main

● Curb Box

TAX ID# 302.12-19-7

LSM-5C 5 15-48