LABOR AND MATERIALS

1	Copper / ~~Lead~~ Connection 3/4	$ 2.94
1	Curb { Cock / ~~Valve~~ / ~~T. S. & V.~~ } 3/4 in.	$ 3.71
1	Service box Old returned { Short 3½X4½ / ~~Long 4½X5½~~ / Buff or Rdway }	$ 5.90
8	Ft. 3/4 in. { Copper / ~~G. I.~~ / ~~C. I.~~ } Pipe at 30	$ 2.40
	Nipples ..... in. at	$
	Bushings ..... to ..... in. at	$
	Red'g / Inc'g Coupl'gs ..... to ..... in. at	$
	Union ..... in. at	$
	Meter ..... in. at	$
	Lead Joints at	$
	Compound Joints at	$
3	Hrs. Water Maint. Man—1 at 101	$ 3.03
	Hrs. Water Maint. Man—2 at	$
10	Hrs. Labor— ....at 80	$ 8.00
	Hrs. Labor— ....at	$
	Hrs. Compressor at	$
	Compensation Ins. at $ ..... per C	$ .24
	Trucking	$ 1.—
	Pav't Patch Before Paving	$
	Tap by Miller	$
		$
		$
	O'head	$
		$ 27.77

107

~~St.~~ Pl. Ave. No. 18

Terra Cotta

Name of Owner

Walter Parsons

Labor and Mat'l. Report July 9 19 48

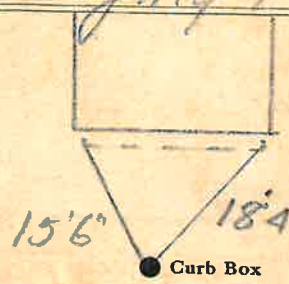

6 Main — Elev. of Main at tap 4

Gate at ● — ● Gate at

¾" Npple — 8' to MAIN

● Curb Box

TAX ID# 302.12-7-20

LSM-5C 5 15-48 to be Changed. ✓