LABOR AND MATERIALS

1	Copper / ~~Lead~~ Connection	3/4	$ 2.94
1	Curb — Cock / Valve / T. S. & V.	3/4 in.	$ 3.71
1	Service box — Short 3½X4½ / ~~Long 4½X5½~~ / ~~Buff or Rdway~~ Old returned		$ 5.90
22 Ft.	3/4 in. — Copper / ~~G. I.~~ / ~~C. I.~~ Pipe at 30		$ 6.60
	Nipples ... in. at		$
	Bushings ... to ... in. at		$
	Red'g Inc'g Coupl'gs ... to ... in. at		$
	Union ... in. at		$
	Meter ... in. at		$
	Lead Joints at		$
	Compound Joints at		$
3	Hrs. Water Maint. Man—1 at	1.01	$ 3.03
	Hrs. Water Maint. Man—2 at		$
10	Hrs. Labor— ... at	80	$ 8.00
	Hrs. Labor— ... at		$
	Hrs. Compressor at		$
	Compensation Ins. at $ ... per C		$ .24
	Trucking		$ 1.—
	Pav't Patch Before Paving		$
	Tap by Miller		$
			$
			$
	O'head		$
			$ 31.47

108

Terra Cotta St. ~~Pl.~~ Ave. No. 19

Name of Owner

Mrs Elma Philo

Labor and Mat'l. Report July 6 19 48

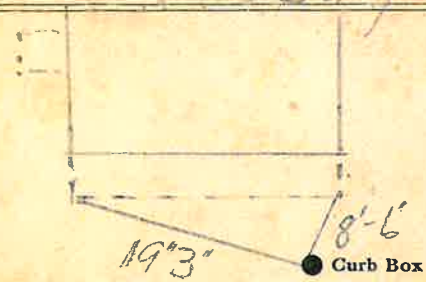

6 Main

Elev. of Main at tap 7

Gate at ● 3/4"

● Gate at 22' to mpin

● Curb Box

TAX ID # 302.12-10-8

LSM-5C 5 15-48 To be Billed ✓