LABOR AND MATERIALS

1 Copper / Lead { Connection 3/4 ..... $ 2.94

1 Curb { Cock / Valve / T. S. & V. } 3/4 ... in. ..... $ 3.71

1 Service box { Short 3½X4½ / Long 4½X5½ / Buff or Rdway } / Old returned ..... $ 5.90

19 Ft. 3/4 in. { Copper / G. I. / C. T. } Pipe at 30 $ 5.70

..... Nipples ..... in. at ..... $ .....

..... Bushings ..... to ..... in. at ..... $ .....

..... Red'g / Inc'g { Coupl'gs ..... to ..... in. at ..... $ .....

..... Union ..... in. at ..... $ .....

..... Meter ..... in. at ..... $ .....

..... Lead Joints at ..... $ .....

..... Compound Joints at ..... $ .....

3 Hrs. Water Maint. Man—1 at 1.01 $ 3.03

..... Hrs. Water Maint. Man—2 at ..... $ .....

10 Hrs. Labor— ....at ..... 80 $ 8.00

..... Hrs. Labor— ....at ..... $ .....

..... Hrs. Compressor at ..... $ .....

..... Compensation Ins. at $ ..... per C .... $ .24

..... Trucking ..... $ 1.—

..... Pav't Patch Before Paving $ —

Tap & Miller ..... $ .....

..... $ .....

..... $ .....

..... O'head ..... $ .....

$ 30.52

110

Terra Cotta St. / Pl. Ave. No. 27

Name of Owner

Roy Cleavert

Labor and Mat'l. Report July 9 19 48

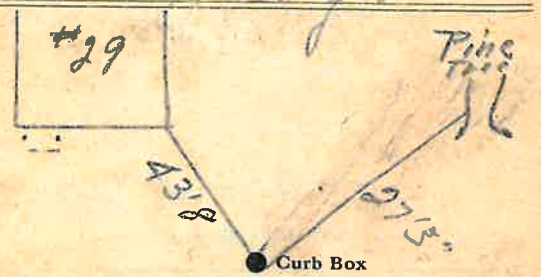

6 Main Elev. of Main at tap 4

Gate at ● ● Gate at

3/4 Tripp 19"to MAIN

● Curb Box

LSM-5C 8 15-48

Lot Tap Bill