Labor and Materials

1	Copper / Lead — Connection 3/4	$ 1.23
1	Curb — Cock / Valve / T. S. & V. 3/4 in	$ 1.68
1	Service Box Old returned — Short 3½ x 4½ / Long 4½ x 5½ / Buff. or Rdway	$ 1.75
19	Ft. 3/4 in. — Copper / Galv Iron / Cast Iron — Pipe at .15	$ 2.85
	Nipples ... in. at	$
	Bushings ... to ... in. at	$
	Red'g / Inc'g — Conplings ... to ... in. at	$
	Union ... in. at	$
	Meter ... in. at	$
	Lead Joints at	$
	Leadite Joints at	$
	Hrs. Foreman at	$
4	Hrs. Chauffeur at .62½	$ 2.50
	Hrs. Tapper at	$
9	Hrs. Labor at .45	$ 4.05
	Hrs. Labor at	$
	Hrs. Compressor at	$
	Compensation Ins.	$ .20
	Trucking	$ 1.00
	Builders Use of Water Patch	$ 5.00
	Tap by Power	$
		$
		$
		$
		$ 20.26

4 7 - 1938

St. / Pl. / Ave. No. 7

Name of Owner

Labor and Mat'l. Report July 28 1938

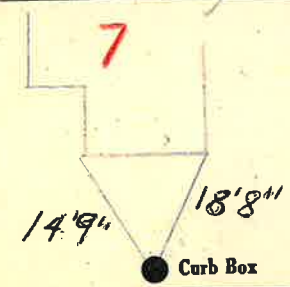

6 Main

Elev. of Main at tap 5

Gate at 3/4" Copper

Gate at 19' to main

Curb Box

TAX ID# 302.12-10-14

old shut off