LABOR AND MATERIALS

Copper Lead } Connection ..... $.....

Curb { Clock / Valve / T. S. & V. } ..... in. ..... $.....

Service box Old returned { Short 3½X4½ / Long 4½X5½ / Buff or Rdway } ..... $.....

..... Ft. ..... in. { Copper / Galv. Iron / Cast Iron } Pipe at ..... $.....

..... Nipples ..... in. at ..... $.....

..... Bushings ..... to ..... in. at ..... $.....

Red'g Inc'g } Couplings ..... to ..... in. at ..... $.....

..... Union ..... in. at ..... $.....

..... Meter ..... in. at ..... $.....

..... Lead Joints at ..... $.....

..... Compound Joints at ..... $.....

..... Hrs. Foreman at ..... $.....

..... Hrs. Chauffeur at ..... $.....

..... Hrs. Tapper at ..... $.....

..... Hrs. Labor at ..... $.....

..... Hrs. Labor at ..... $.....

..... Hrs. Compressor at ..... $.....

..... Compensation Ins. ..... $.....

..... Trucking ..... $.....

..... Builders Use of Water. ..... $.....

Measured Warsinske & Geo ..... $.....

..... $.....

..... $.....

..... $.....

$.....

St. ~~Pl.~~ 31

Terra Cotta Ave. No. 29

Name of Owner

Labor and Mat'l. Report Dec 11 19[illegible]

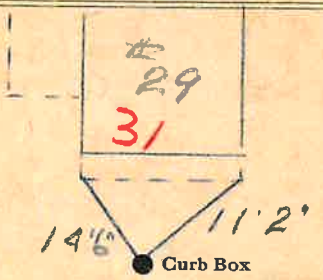

..... Main Elev. of Main at tap .....

Gate at ● ● Gate at

● Curb Box

LSM-SC-6-1-45