Labor and Materials

1	Copper ~~Lead~~ Connection	3/4	$ 1.23
1	Curb ~~Cock~~ ~~Valve~~ ~~T. S. & V.~~	3/4 in	$ 1.68
1	Service Box ~~Old returned~~ ~~Short 3½ x 4½~~ Long 4½ x 5½ ~~Buff. or Rdway.~~		$ 1.75
23	Ft. 3/4 in. Copper ~~Galv. Iron~~ ~~Cast Iron~~ Pipe at		$ 3.45
	Nipples in. at		$
	Bushings to in. at		$
	Red'g Inc'g Couplings to in. at		$
	Union in. at		$
	Meter in. at		$
	Lead Joints at		$
	Leadite Joints at		$
	Hrs. Foreman at		$
3	Hrs. Chauffeur at	62½	$ 1.86
4	Hrs. Tapper at	-	$ 2.50
4	Hrs. Labor at	.45	$ 1.80
	Hrs. Labor at		$
	Hrs. Compressor at		$
	Compensation Ins.		$ .19
	Trucking		$ 1.00
	Builders Use of Water	Patch	$ 5.00
	Traffic Permit		$
			$
			$
			$
			$ 20.48

8-9-1938

~~St.~~ ~~Pl.~~ Terra Cotta Ave. No. 35 37

Name of Owner

Wilcox

Labor and Mat'l. Report 6-3-38 19

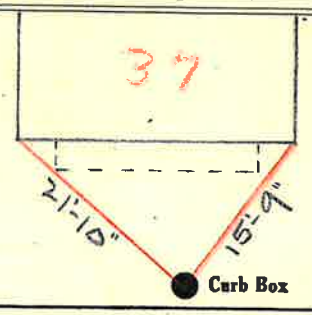

6 Main Elev. of Main at tap 5

Gate at ● ~~3/4~~ Stopper ● Gate at 23' to main

● Curb Box

TAX ID# 302.12-10-1

Old tap disconnected.