LABOR AND MATERIALS

1	Copper Lead	Connection 3/4	$ 2.94
1	Curb Cock / Valve / T. S. & V.	3/4 in.	$ 3.71
1	Service box Old returned	Short 3½X4½ / Long 4½X5½ / Buff or Rdway	$ 5.90
8	Ft. 3/4 in.	Copper / G. I. / C. I. Pipe at 30	$ 2.40
	Nipples ... in. at		$
	Bushings ... to ... in. at		$
	Red'g Inc'g Coupl'gs ... to ... in. at		$
	Union ... in. at		$
	Meter ... in. at		$
	Lead Joints at		$
	Compound Joints at		$
3	Hrs. Water Maint. Man—1 at	1.01	$ 3.03
	Hrs. Water Maint. Man—2 at		$
10	Hrs. Labor— at	$0	$ 4.00
	Hrs. Labor— at		$
	Hrs. Compressor at		$
	Compensation Ins. at $ ... per C		$ .24
	Trucking		$ 1.00
	Pav't Patch Before Paving		$
	Tap by Meguire		$
			$
			$
	O'head		$
			$ 27.22

105

St.
Pl.
Ave. No. 11

Terra Cotta

Name of Owner

Garilla Taylor

Labor and Mat'l. Report July 13 19 1

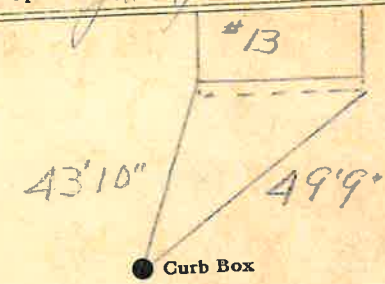

6 Main

Elev. of Main at tap 5

Gate at ● ● Gate at

3/4" copper 8' to main

● Curb Box

LSM-SC 5 15-48

Hot tap to be billed ✓