LABOR AND MATERIALS

1	Copper ~~Lead~~ Connection	3/4"	$ 3.20
1	Curb {Clock Valve ~~T. S. & V.~~}	3/4 in.	$ 1.00
1	Service box Old returned {Short 3½X4½ ~~Long 4½X5½~~ ~~Buff or Rdway~~}		$ 1.30
26	Ft. 3/4 in. {Copper ~~Galv. Iron~~ ~~Cast Iron~~}	Pipe at	$ 5.72
	Nipples	in. at	$
	Bushings	to in. at	$
	Red'g Inc'g Couplings	to in. at	$
	Union	in. at	$
	Meter	in. at	$
	Lead Joints at		$
	Compound Joints at		$
12	Hrs. Foreman at		$ 7.50
	Hrs. Chauffeur at		$
	Hrs. Tapper at		$
2	Hrs. Labor at		$ 1.00
11	Hrs. Labor at		$ 4.47
	Hrs. Compressor at		$
	Compensation Ins.		$ .34
	Trucking		$ 1.00
	Builders Use of Water		$
			$
			$
			$
			$

25.53

28-150

St. ~~Pl.~~ 76

Third

~~Aver~~ No. 22

Name of Owner

Labor and Mat'l. Report Nov. 3 1928

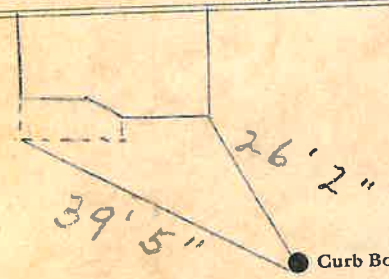

6 Main

Elev. of Main at tap 5

Gate at ● ● Gate at

3/4" Copper 26' to main

● Curb Box

Old Tap Shut off

TAX ID # 309.12-13-14

LSM-5C-6-1-45