LABOR AND MATERIALS

1	Copper / ~~Lead~~ Connection 3/4	$ 1.23
1	Curb { Cock / ~~Valve~~ / T. S. & V. } 3/4 in.	$ 1.68
1	Service Box Old returned { Short 3½x4½ / Long 4½x5½ / Buff. or Rdway }	$ 1.54
13	Ft. 3/4 in. { Copper / Galv Iron / Cast Iron } Pipe at 17	$ 2.21
	Nipples ____ in. at	$
	Bushings ____ to ____ in. at	$
	Red'g / Inc'g } Couplings ____ to ____ in. at	$
	Union ____ in. at	$
	Meter ____ in. at	$
	Lead Joints at	$
	Leadite Joints at	$
	Hrs. Foreman at	$
	Hrs. Chauffeur at	$
5	Hrs. Tapper at 62½c	$ 3.13
5	Hrs. Labor at 45	$ 2.25
	Hrs. Labor at	$
	Hrs. Compressor at	$
	Compensation Ins.	$
	Trucking	$ 1.17
	Builders Use of Water Patch	$ 5.—
	Tapping Hessel	$
		$
		$
		$
		$ 18.21

S 8 - - 1939

St. / Pl. / Ave. No. 27

Third

Name of Owner

Granger

Labor and Mat'l. Report June 27 1939

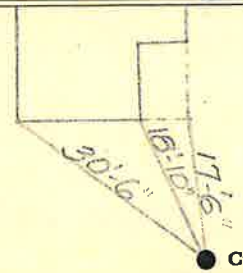

6 Main — Elev. of Main at tap 5'

Gate at ● — ● Gate at

3/4" COPPER — 13' to MAIN

● Curb Box

TAX ID# 309.12-10-31

old Shut off