LABOR AND MATERIALS

1	Copper / ~~Lead~~ Connection 1"	$ 4.28
1	Curb { Cock / ~~Valve~~ / ~~T. S. & V.~~ } 1 in.	$ 5.25
1	Service box / ~~Old returned~~ { Short 3½ x 4½ / ~~Long 4½ x 5½~~ / ~~Buff or Rdway~~ }	$ 4.69
24	Ft. 1 in. { Copper / ~~C. I.~~ / ~~C. I.~~ } Pipe at .56	$ 13.44
	Nipples in. at	$
	Bushings to in. at	$
	Red'g / Inc'g Coupl'gs to in. at	$
	Union in. at	$
	Meter in. at	$
	Lead Joints at	$
	Compound Joints at	$
	Maintenance Foreman	$ 18.66
	Hrs. Water Maint. Man—1 at	$
8	Hrs. Water Maint. Man—2 at 1.24	$ 9.92
	Hrs. Garage Foreman at	$
8	Hrs. Labor— at 1.13	$ 9.04
	Hrs. Compressor at	$
	Compensation Ins. at $ 4.29 per C	$ 80
	Trucking	$ 1.50
	Pav't Patch	$ 25.20
Tap by Gifford 10-3-55		$
		$
		$
	O'head	$
		$ 73.82

St. ~~Pl.~~ Ave. No. 28

Third

Name of Owner TAX ID # 309.12-13-110

Gordon

Labor and Mat'l. Report Oct. 3, 1955

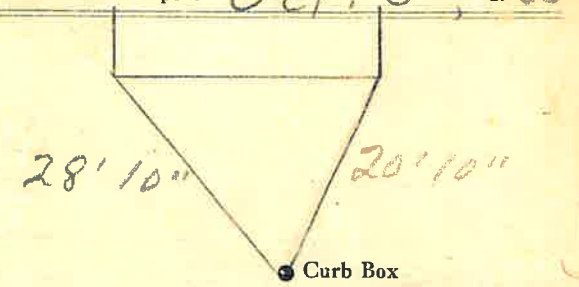

6" Main

Elev. of Main at tap 5'

Gate at • • Gate at

1" Copper 24' to main

• Curb Box

Old Taps Dug up and Disconnected 10-4-55

L M—SC—2-1-54