Labor and Materials

1	Copper / ~~Lead~~ Connection	$ 2.60
1	Curb { Cock / Valve / T. S & V. } ..... in.	$ 2.30
1	Service Box / Old returned { Short 3½x4½ / ~~Long 4½x5½~~ / ~~Buff. or Rdway~~ }	$ 1.40
22	Ft. ..... in. { Copper / ~~Galv. Iron~~ / ~~Cast Iron~~ } Pipe at	$ 5.83
	Nipples ..... in. at	$
	Bushings ..... to ..... in. at	$
	Red'g / Inc'g Couplings ..... to ..... in. at	$
	Union ..... in. at	$
	Meter ..... in. at	$
	Lbs. Br. Stone at	$
	Lbs. Sand at	$
	Bags Cement at	$
	Paving Brick { Mack / Red / Asphalt } at	$
	Lead Joints at	$
	Leadite Joints at	$
5	Hrs. Foreman at	$ 2.82
~~22~~	Hrs Common Labor at	$ 8.94
	Hrs. Common Labor at	$
	Hrs Mason at	$
	Hrs Mason's Helper at	$
1	Hrs. Compressor at	$ 1.50
	Compensation Ins	$ .31
	Trucking	$ 1.00
	~~Builders' Use of Water~~ Patch	$ 5.00
	Total	$ 31.70

29-217

Labor and Material Report 12 - 27 1930

~~31~~ 24 Third St.

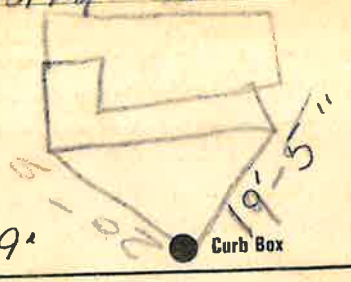

6 Main — Elev of Main at tap 5

Gate at ● — ● Gate at

3/4" copper 22' to MAIN

● Curb Box

TAX ID# 309.12-13-18

old Taps disconected