LABOR AND MATERIALS

1	Copper / ~~Lead~~ Connection 3/4	$ 2.29
1	Curb { Cock / ~~Valve~~ / ~~T. S. & V.~~ } 3/4 in.	$ 2.70
1	Service box / Old returned { Short 3½x4½ / Long 4½x5½ / Buff or Rdway }	$ 4.25
21	Ft. 3/4 in. { Copper / ~~G. I.~~ / ~~C. I.~~ } Pipe at	$ 7.35
	Nipples in. at	$
	Bushings to in. at	$
	Red'g / Inc'g { Coupl'gs to in. at	$
	Union in. at	$
	Meter in. at	$
	Lead Joints at	$
	Compound Joints at	$
	Hrs. Water Maint. Man—1 at	$
5	Hrs. Water Maint. Man—2 at 1.02	$ 5.10
5	Hrs. Labor— at 91	$ 4.55
	Hrs. Labor— at	$
	Hrs. Compressor at	$
	Compensation Ins. at $ per C.	$ 1.21
	Trucking	$
	Pav't Patch	$ 12.83
	Lap & Mozzian	$
		$
		$
	O'head	$
		$ 40.28

Third St St. Pl. Ave. No. 36

Name of Owner McGarr

Labor and Mat'l. Report June 1 1950

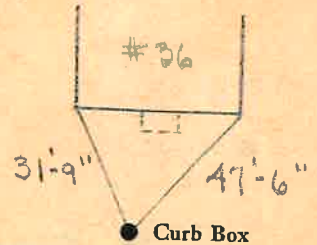

6 Main — Elev. of Main at tap 5

Gate at ● 3/4" Copper — ● Gate at 21' to main

● Curb Box

TAX ID# 309.12-13-20

LSM-5C 10-21-49