Labor and Materials

Copper / Lead } Connection ..... $

Curb { Cock / Valve / T. S. & V. } ..... in ..... $

Service Box / Old returned { Short 3½ x 4½ / Long 4½ x 5½ / Buff. or Rdway } ..... $

.....Ft. .....in. { Copper / Galv Iron / Cast Iron } Pipe at ..... $

..... Nipples .....in. at ..... $

.....Bushings ..... to ..... in. at ..... $

Red'g / Inc'g } Couplings ..... to ..... in. at ..... $

.....Union ..... in. at ..... $

.....Meter .....in. at ..... $

.....Lead Joints at ..... $

.....Leadite Joints at ..... $

.....Hrs. Foreman at ..... $

.....Hrs, Chauffeur at ..... $

.....Hrs. Tapper at ..... $

.....Hrs. Labor at ..... $

.....Hrs. Labor at ..... $

.....Hrs. Compressor at ..... $

.....Compensation Ins. ..... $

.....Trucking ..... $

.....Builders Use of Water ..... $

..... $

..... $

..... $

..... $

$

St. / ~~Pl.~~ Ave. No. 44

Third

Name of Owner

Lennox

Labor and Mat'l. Report 11 - 6 - 20 19

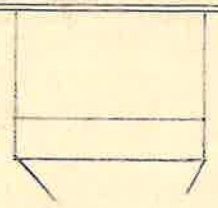

Curb Box

4 Main

Elev. of Main at tap 4

Gate at •

• Gate at

Curb Box

TAX ID # 309.11-11-3