LABOR AND MATERIALS

	Copper / Lead } Connection	Same	$ —
1	Curb { Cock / Valve / T. S. & V. }	3/4 in.	$ 1.80
1	Service Box / Old returned { Short 3½x4½ / Long 4½x5½ / Buff or Rdway }		$ 1.82
14	Ft. 3/4 in. { Copper / Galv Iron / Cast Iron } Pipe at .18	Tubeloy	$ 2.52
	Nipples ... in. at		$
	Bushings ... to ... in. at		$
2	~~Red'g~~ / ~~Inc'g~~ } Couplings ... to ... in. at	Lead to Iron	$ .30
	Union ... in. at		$
	Meter ... in. at		$
	Lead Joints at		$
	Leadite Joints at		$
	Hrs. Foreman at		$
	Hrs. Chauffeur at		$
7	Hrs. Tapper at	68¾	$ 4.81
7	Hrs. Labor at	60	$ 4.20
	Hrs. Labor at		$
1	Hrs. Compressor at	87½	$ .88
	Compensation Ins.	2.213	$ .20
	Trucking		$ 1.00
	Builders Use of Water		$ 7.80
	Tap by Hessel		$
			$
	1-Hole 5X4		$
			$
			$ 25.33

Third St. ~~Pl.~~ ~~Ave.~~ No. 56

Name of Owner

Normandin

Labor and Mat'l. Report Aug 9 1943

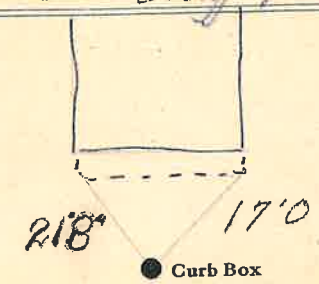

4 Main

Elev. of Main at tap 4

Gate at 3/4"

Gate at 14' to MAIN

Curb Box

TAX ID# 309.11-11-9