Labor and Materials

.....	Copper / Lead	Connection	$.....
.....	Curb	Cock / Valve / T. S. & V. ..... in	$.....
.....	Service Box / Old returned	Short 3½ x 4½ / Long 4½ x 5½ / Buff. or Rdway	$.....
.....Ft.	.....in.	Copper / Galv Iron / Cast Iron — Pipe at	$.....
.....	Nipples	.....in. at	$.....
.....	Bushings	.....to .....in. at	$.....
.....	Red'g / Inc'g	Couplings .....to .....in. at	$.....
.....	Union	.....in. at	$.....
.....	Meter	.....in. at	$.....
.....	Lead Joints at		$.....
.....	Leadite Joints at		$.....
.....	Hrs. Foreman at		$.....
.....	Hrs. Chauffeur at		$.....
.....	Hrs. Tapper at		$.....
.....	Hrs. Labor at		$.....
.....	Hrs. Labor at		$.....
.....	Hrs. Compressor at		$.....
.....	Compensation Ins.		$.....
.....	Trucking		$.....
.....	Builders Use of Water		$.....
.....			$.....
.....			$.....
.....			$.....
.....			$.....
			$.....

Third St St. / Pl. / Ave. No. .....

Name of Owner

for drinking fountain at Big Cross School

Labor and Mat'l. Report April 7-38 19

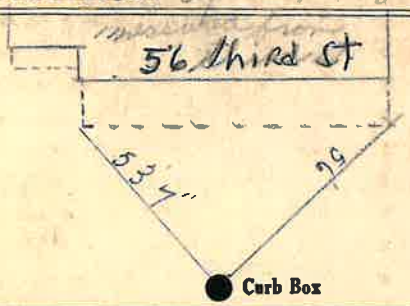

.....Main Elev. of Main at tap..... .....

Gate at • • Gate at

• Curb Box

On City Hall records as on Big Cross St.